
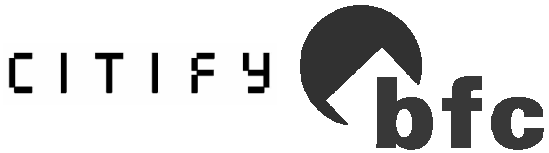



B	CONSTRUCTION ISSUE	24.03.20	MS	
A	CONSTRUCTION ISSUE	14.02.20	MS	
REV N	DESCRIPTION	DATE	CHKD	

FOR CONSTRUCTION

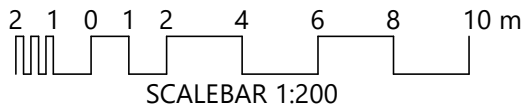

**LUCID**  
CONSULTING AUSTRALIA  
Level 3/169, Pirie St Adelaide SA 5000  
Phone: (08) 8407 9700  
Email: adelaide@lucidconsulting.com.au

PROJECT  
HYDE PARK PLACE  
248 UNLEY ROAD, HYDE PARK  
ELECTRICAL SERVICES  
DRAWING  
SITE PLAN

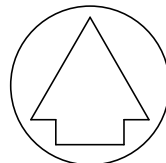

NOT FOR CONSTRUCTION PURPOSES UNLESS STAMPED FOR CONSTRUCTION. VERIFY DIMENSIONS AND LEVELS ON SITE BEFORE SETTING OUT. DO NOT SCALE. REFER TO FIGURED DIMENSIONS - IN mm UNLESS OTHERWISE STATED.

Scale	Design: MD	No. in Set	Date
1 : 200	Drawn: PY Review: PAC	3 of 24	FEB 2020

Orig. Size	Drawing no.	Revision
A1	LCE14462-E100	B