

PUMP EXHAUST TO DISCHARGE EXTERNALLY AT HIGH LEVEL.

PROVIDE HORN SPEAKERS WITHIN CARPARK AREA TO BE LOCATED ON STRUCTURAL COLUMN (TYPICAL).

MONITORED ISOLATION VALVE ON GROUND LEVEL CAR PARK SPRINKLER SUPPLY. SUPPLY AND INSTALL NON-FERROUS METALLIC SIGNAGE WITH TEXT 'GROUND LEVEL CAR PARK SPRINKLER ISOLATION VALVE NORMALLY LOCKED OPEN' WITH 003 LOCK AND CHAIN.

RETAIL SPRINKLER SUPPLY FROM PRESSURE REDUCING STATION WITHIN FIRE PUMP ROOM ON BASEMENT LEVEL.

SAMFS BRIGADE BOOSTER ASSEMBLY COMPLETE WITH:
• 1500 QUAD FEED HYDRANT (TOWN'S MAIN SUPPLIED)
• 1500 QUAD BOOSTER (COMBINED SPRINKLER HYDRANT SYSTEM BOOSTER)

PROVIDE EXTERNAL STROBE ADJACENT TO BOOSTER ASSEMBLY TO INDICATE PUMP RUN.

Fire exhaust peno 250mm in from corner of precast

MONITORED ISOLATION VALVE ON TENANCY SPRINKLER SUPPLY. SUPPLY AND INSTALL NON-FERROUS METALLIC SIGNAGE WITH TEXT 'TENANCY SPRINKLER ISOLATION VALVE NORMALLY LOCKED OPEN' WITH 003 LOCK AND CHAIN.
PROVIDE PORTABLE FIRE EXTINGUISHER WITHIN TENANCY AREAS. REFER TO DRAWING LCE14462-F300 FOR DETAIL (TYPICAL).

PROVIDE WINDOW WETTING SPRINKLER TO BE INSTALLED IN ACCORDANCE WITH AS2118.1 FOR PROTECTION OF OPENINGS ON EAST FACADE.

MONITORED ISOLATION VALVE ON WINDOW WETTING SPRINKLER SUPPLY. SUPPLY AND INSTALL NON-FERROUS METALLIC SIGNAGE WITH TEXT 'WINDOW WETTING SPRINKLER ISOLATION VALVE NORMALLY LOCKED OPEN' WITH 003 LOCK AND CHAIN.

PROVIDE SIDE WALL SPRINKLERS WITHIN EACH BIN CHUTE COMPLETE WITH DUST BOX IN ACCORDANCE WITH AS2118.1-2017. FIRE CONTRACTOR TO COORDINATE WITH BUILDING SERVICES TRADE TO ENSURE SPRINKLER LOCATIONS ARE MECHANICALLY PROTECTED.

1500 FH FROM BELOW TO ABOVE.

SUPPLY AND INSTALL THE FIRE DETECTION CONTROL AND INDICATING EQUIPMENT (FDCIE) WHICH INCLUDES THE FIRE INDICATOR PANEL (FIP) AND EMERGENCY CONTROL PANEL (ECP) WITHIN THE MAIN ENTRY LOBBY. PROVIDE REMOTE PUMP CONTROLS AT FDCIE.

VOID TO ABOVE.

INSTALL EXTERNAL 'FIRE' STROBE ON THE BUILDING FACADE FACING UNLEY ROAD. FIRE SERVICES CONTRACTOR TO PROVIDE ALL ASSOCIATED CABLING AND COMPLETE FINAL CONNECTION TO FDCIE. COORDINATE FINAL LOCATION OF STROBE WITH ARCHITECT.

PROVIDE SURFACE-MOUNTED OCCUPANT WARNING SPEAKERS WITHIN TENANCY AREAS TO COMPLY WITH AS1670.1 (TYPICAL).

ISOLATION VALVE NORMALLY OPEN ON 500 FIRE HOSE REEL SUPPLY CONNECTED TO COMBINED FIRE HYDRANT AND SPRINKLER RISER. PROVIDE NON-FERROUS METAL TAG WITH WORDING 'FIRE SERVICE VALVE CLOSE ONLY TO SERVICE FIRE HOSE REELS' IN ACCORDANCE WITH AS2419.1 CLAUSE 8.5.11.3.

1500 FH FROM BELOW.

1500 FH TO ABOVE.

500 AS2118.6-2012 SPRINKLER CONTROL ASSEMBLY LOCATED WITHIN THE FIRE-ISOLATED PASSAGEWAY AND SUPPLIED OFF THE COMBINED FIRE HYDRANT AND SPRINKLER RISER.

MONITORED ISOLATION VALVE ON TENANCY SPRINKLER SUPPLY. SUPPLY AND INSTALL NON-FERROUS METALLIC SIGNAGE WITH TEXT 'TENANCY SPRINKLER ISOLATION VALVE NORMALLY LOCKED OPEN' WITH 003 LOCK AND CHAIN.


MONITORED ISOLATION VALVE ON OFFICE TENANCY SPRINKLER SUPPLY. SUPPLY AND INSTALL NON-FERROUS METALLIC SIGNAGE WITH TEXT 'OFFICE TENANCY SPRINKLER ISOLATION VALVE NORMALLY LOCKED OPEN' WITH 003 LOCK AND CHAIN.

PROVIDE SURFACE-MOUNTED SMOKE DETECTOR WITHIN FIRE-ISOLATED STAIRWELL AND FIRE-ISOLATED PASSAGEWAY, SPACED IN ACCORDANCE WITH AS1670.1(TYPICAL).

REV	DESCRIPTION	DATE	CHKD
B	CONSTRUCTION ISSUE	24.03.2020	-
A	CONSTRUCTION ISSUE	14.02.2020	-

© Copyright Lucid Consulting Australia 3/24/2020 2:31:49 PM

FOR CONSTRUCTION

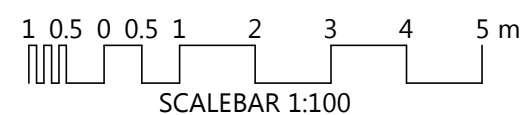

TO BE PRINTED IN COLOUR

THE PURPOSE OF THIS DOCUMENT IS INTENDED TO BE VIEWED OR PRINTED IN COLOUR FOR THE FULL EXTENT OF THE SCOPE OF WORKS TO BE SHOWN.


CITIFY bfc

GEMMA LEA DESIGN STUDIO

LUCID
CONSULTING AUSTRALIA
Level 3/169, Pirie St Adelaide SA 5000
Phone: (08) 8407 9700
Email: adelaide@lucidconsulting.com.au

PROJECT
HYDE PARK PLACE
248 UNLEY ROAD, HYDE PARK
FIRE SERVICES

DRAWING
GROUND FLOOR FIRE SERVICES ARRANGEMENT

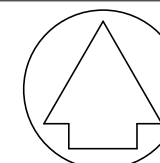

NOT FOR CONSTRUCTION PURPOSES UNLESS STAMPED FOR CONSTRUCTION. VERIFY DIMENSIONS AND LEVELS ON SITE BEFORE SETTING OUT. DO NOT SCALE. REFER TO FIGURED DIMENSIONS - IN mm UNLESS OTHERWISE STATED.

Scale	Design: LM/AR	No. in Set	Date
1 : 100	Drawn: SHA	5 of 14	MAR 2020
Review: -			

Orig. Size	Drawing no.	Revision
------------	-------------	----------

A1 LCE14462-F201 B